


The Examiner's amendments have been approved by the Applicant.  
The drawing changes are also approved: the reference numeral "10"  
has been added to FIGURES 1 and 8; reference numerals "64",  
"70" and "72" have been added to FIGURE 2.

A red-lined drawing showing the changes is attached, along with  
a complete set of formal, corrected drawings.

Respectfully submitted,

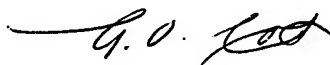

Albert O. Cota  
Agent of Record  
Registration No. 29,291

(818) 368-4332

# RED-LINED DRAWINGS

1/7

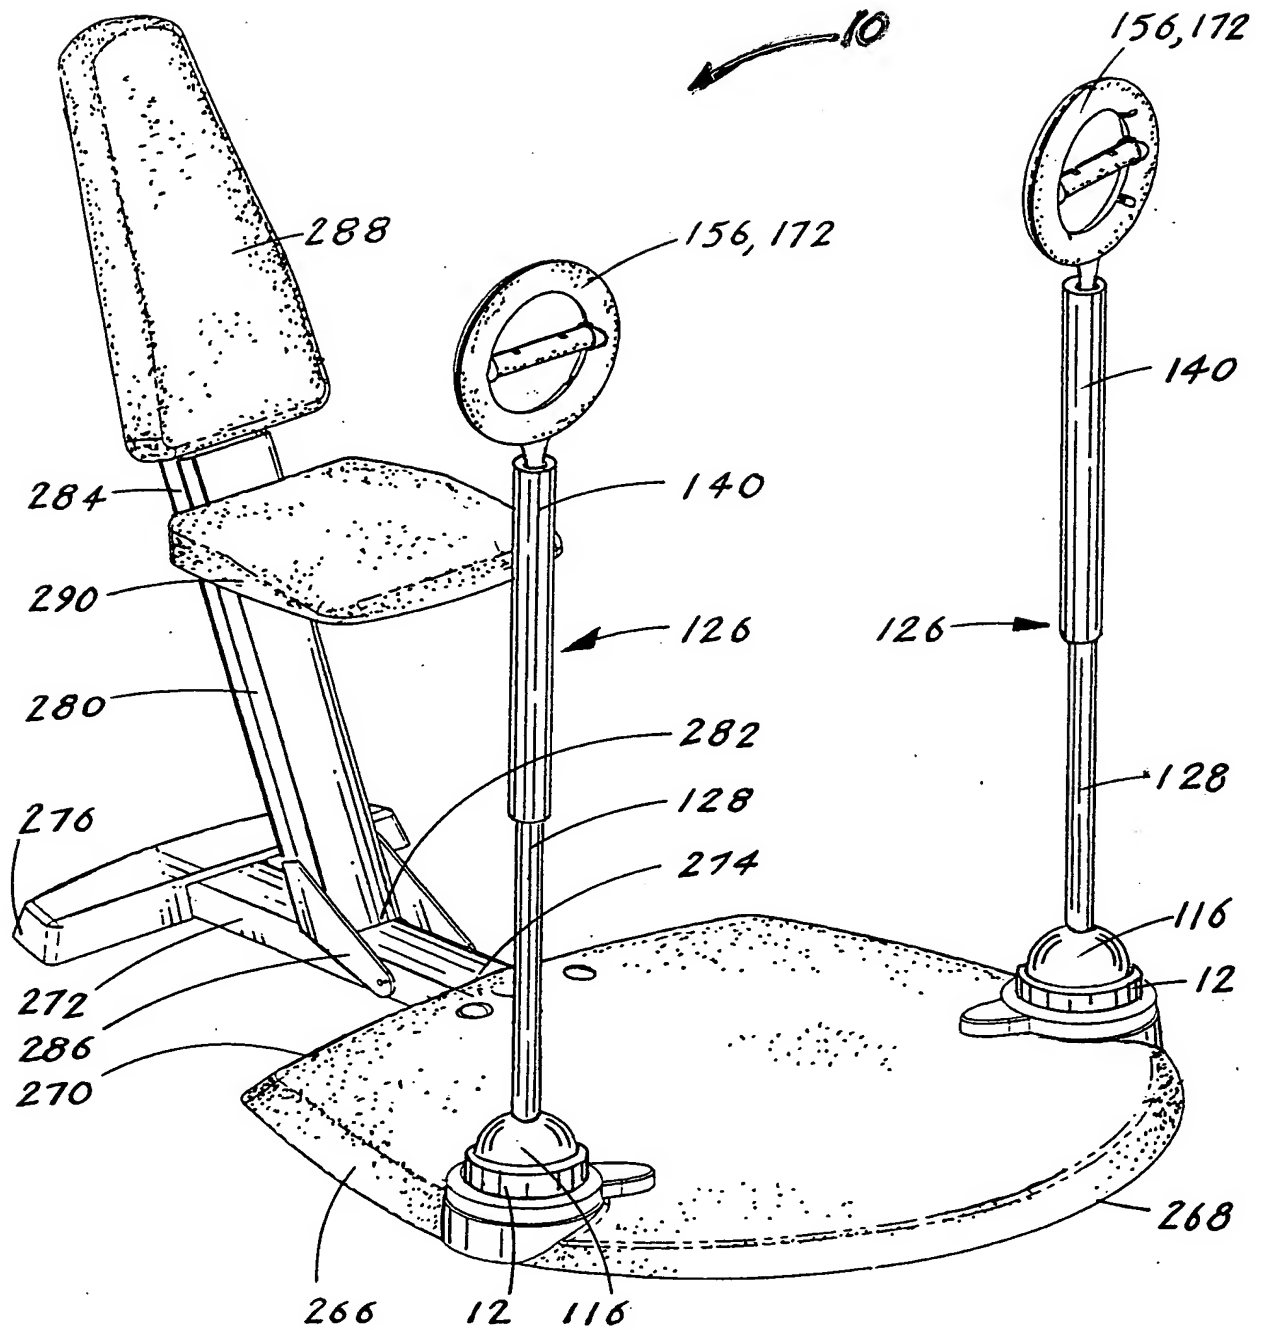


Fig. 1

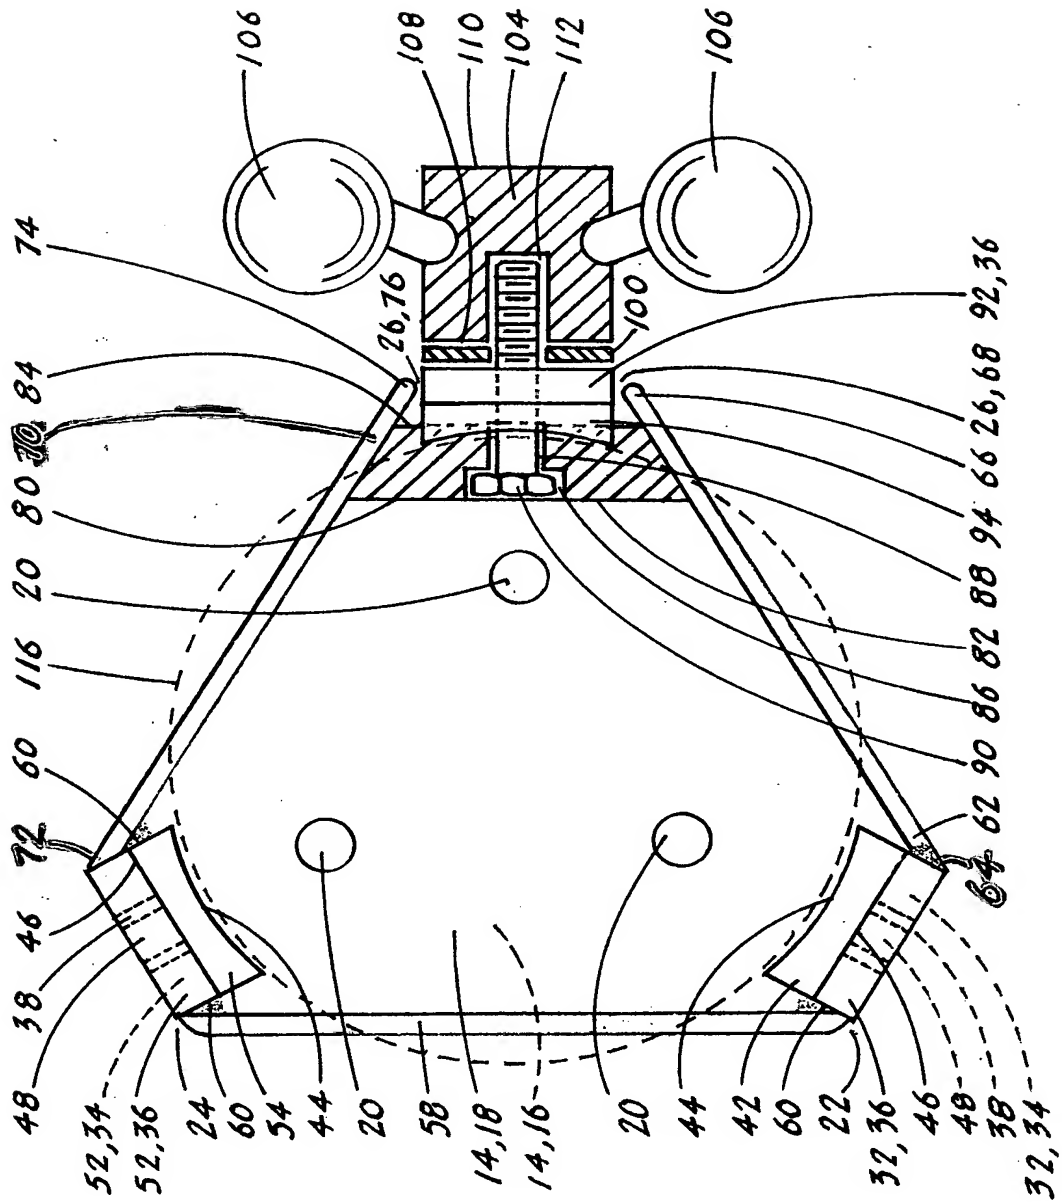
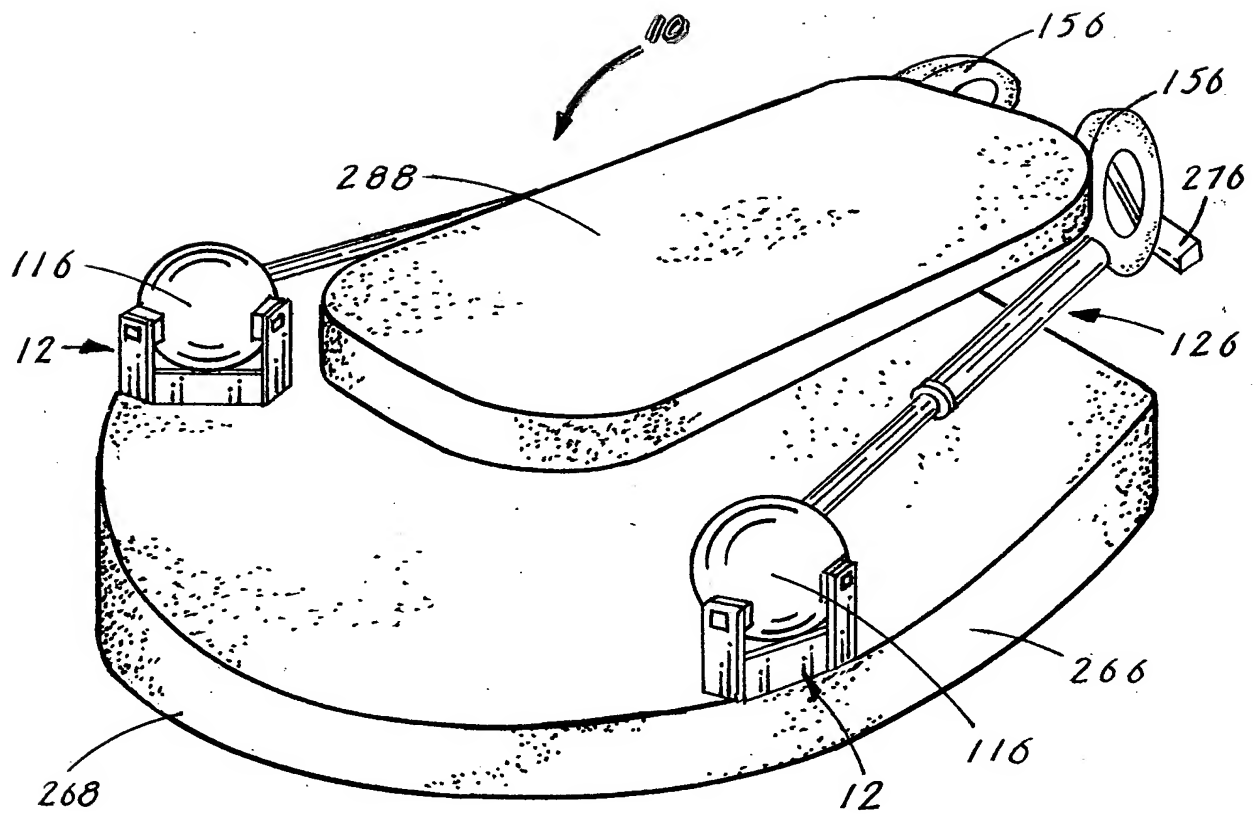


Fig. 2

*Fig. 8*